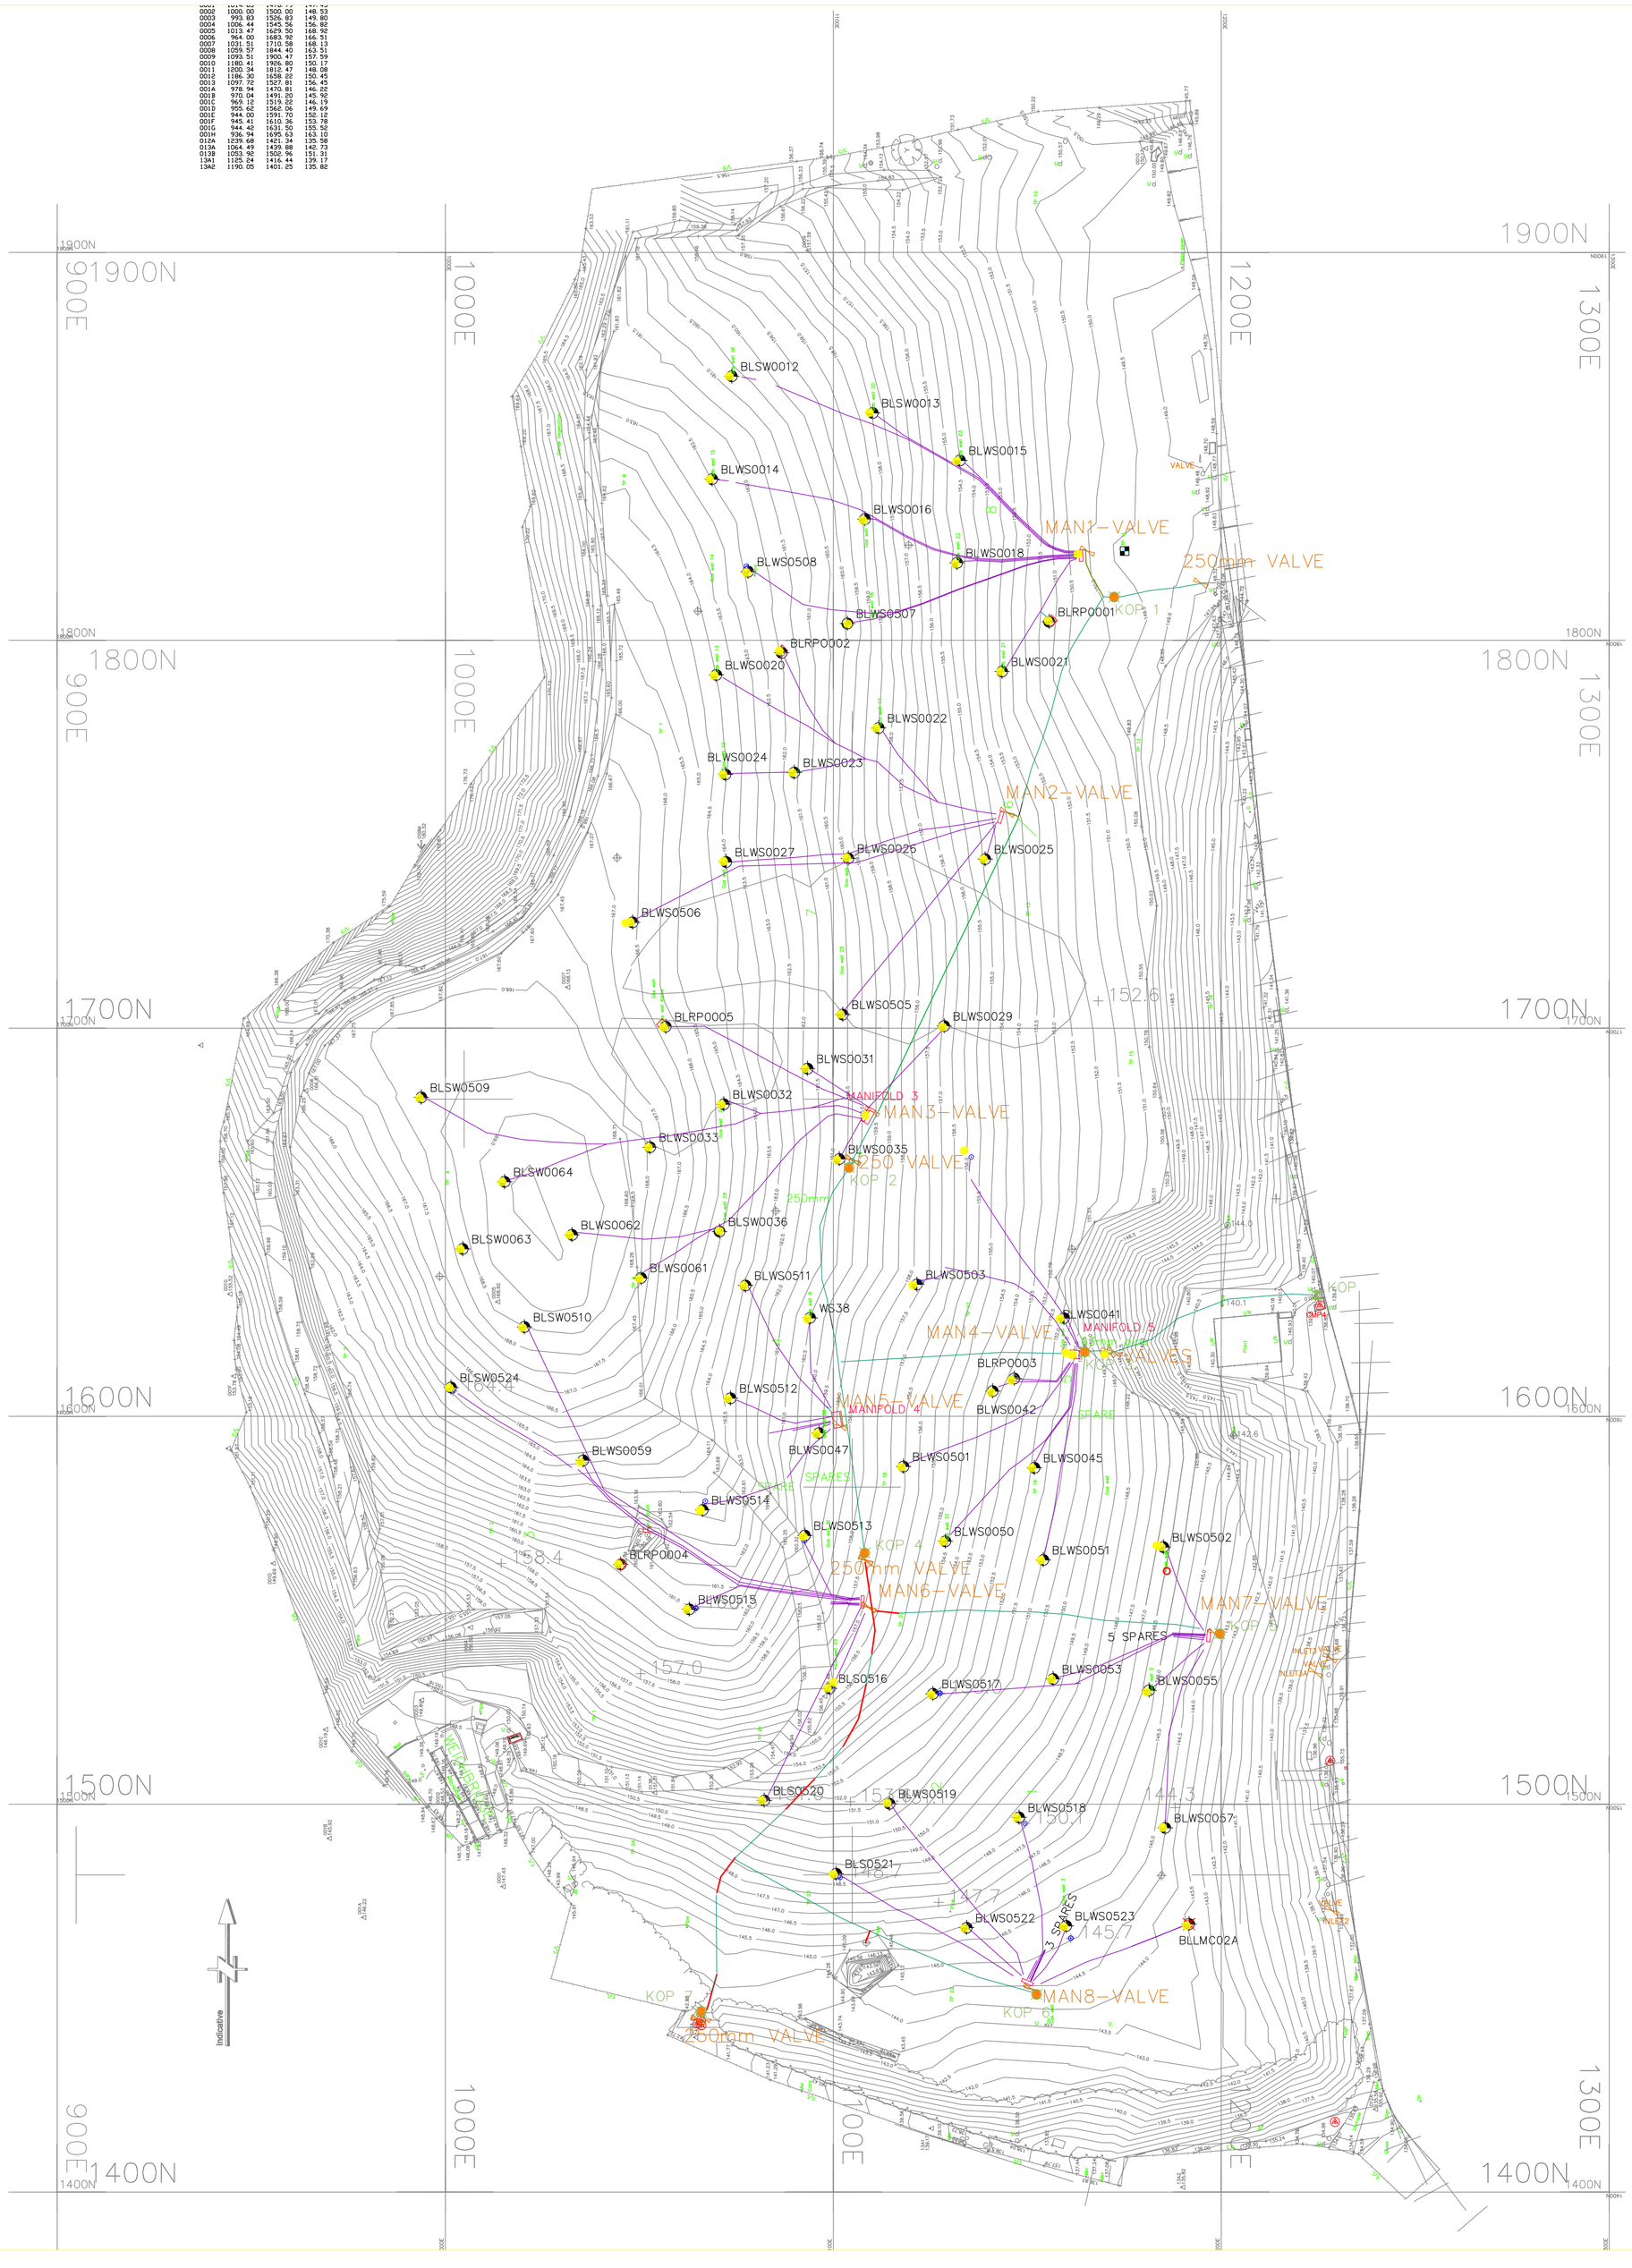

LEGEND

- ASSUMED PIPE LANDFILL GAS
- UNKNOWN SIZE ø GAS MAIN
- 630mm ø GAS MAIN
- 400mm ø GAS MAIN
- 250mm ø GAS MAIN
- 355mm ø GAS MAIN
- 355mm ø GAS MAIN
- 200mm ø GAS MAIN
- 180mm ø GAS MAIN
- 90mm ø LANDFILL GAS
- 63mm ø LANDFILL GAS
- 160mm ø LANDFILL GAS MAIN
- 125mm ø LANDFILL GAS MAIN
- 110mm ø LANDFILL GAS
- 63mm ø LEACHATE / AIR
- 32mm ø AIR / LEACHATE

EXISTING WELL

KO KNOCKOUT POT

Combined leachate and gas well

Proposed well

VALVE

MONITORING POINT

REVISIONS

No	Description	By	Chk'd	Date
A	new well nos added and drg set to OS	MPH		13.12.07

Project:

BILANGE
LANDFILL SITE

Title:

Gas system as built

Drawn By MPH Date 13.12.07

Chk'd By MPH Date

Scale: 1:1000 Sheet Size A1

A1 SHEET

novera energy

Novera Energy Europe Limited Co. No. 0345 1378
Mall Building, Wilderspool Park,
Warrington, Cheshire, WA4 6HH
Phone +44(0) 1925 438 300
Fax +44(0) 1925 438 300

Drawing No
NOV--BILANGE-GS-01A